



MASTER DEED SITE PLAN
 ROUND HOUSE CONDOMINIUM (PHASE II)
 LOWELL, MASS.
 OCT., 1987 · 1" = 20'

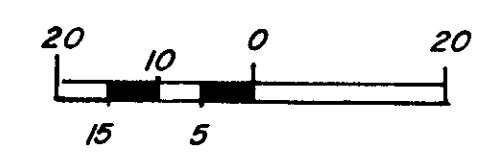

CERTIFICATIONS: 1.) I CERTIFY THAT THIS PLAN FULLY & ACCURATELY
 DEPICTS THE LOCATION AND DIMENSIONS
 OF "ROUND HOUSE CONDOMINIUM, PHASE II,"
 AS-BUILT AND FULLY LISTS THE UNITS
 CONTAINED THEREIN.
 10-27-87 Leo B. White, R.L.S.

D = DECK
 D = DEED
 S = SURVEY

2.) CHAPTER 380; ACTS OF 1966.
 I HEREBY CERTIFY THAT THE PROPERTY LINES
 SHOWN ON THIS PLAN ARE THE LINES DIVIDING
 EXISTING OWNERSHIPS, AND THE LINES OF STREETS
 AND WAYS SHOWN ARE THOSE OF PUBLIC OR
 PRIVATE STREETS OR WAYS ALREADY ESTABLISHED
 AND THAT NO NEW LINES FOR DIVISION OF
 EXISTING OWNERSHIP OR FOR NEW WAYS
 ARE SHOWN. 10-27-87 Leo B. White, R.L.S.

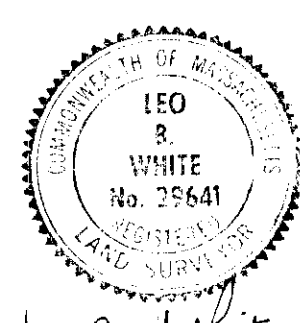

Leo B. White, R.L.S.
 I HEREBY CERTIFY THAT THIS PLAN
 WAS PREPARED IN ACCORDANCE WITH
 THE RULES AND REGULATIONS OF THE
 REGISTRY OF DEEDS.

Nov. 9 1987
 162 83