


MASTER DEED SITE PLAN
 ROUND HOUSE CONDO-
 LOWELL, MASS.
 OCT., 1987 1" = 20'


I CERTIFY THAT THIS PLAN FULLY & ACCURATELY DEPICTS THE LOCATION AND DIMENSIONS OF THE BUILDING AS BUILT AND FULLY LISTS THE UNITS CONTAINED THEREIN.
 W.B. White 10-12-87

CHAPTER 380; ACTS OF 1966.
 I HEREBY CERTIFY THAT THE PROPERTY LINES SHOWN ON THIS PLAN ARE THE LINES DIVIDING EXISTING OWNERSHIPS, AND THE LINES OF STREETS & WAYS SHOWN ARE THOSE OF PUBLIC OR PRIVATE STREETS OR WAYS ALREADY ESTABLISHED AND THAT NO NEW LINES FOR DIVISION OF EXISTING OWNERSHIP OR FOR NEW WAYS ARE SHOWN.

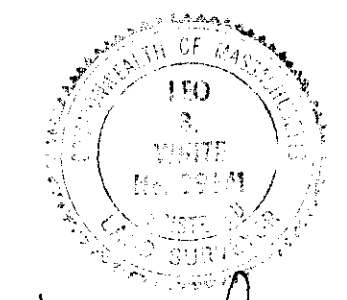

W.B. White, E.L.S., 10-12-87

I HEREBY CERTIFY THAT THIS PLAN WAS PREPARED IN ACCORDANCE WITH THE RULES AND REGULATIONS OF THE BOARD OF DEEDS.

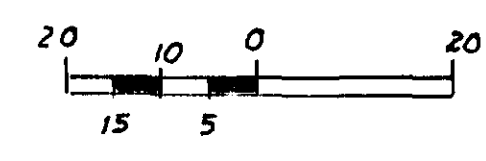

RECEIVED
 OCT. 15, 1987
 162
 1